


631 Milam

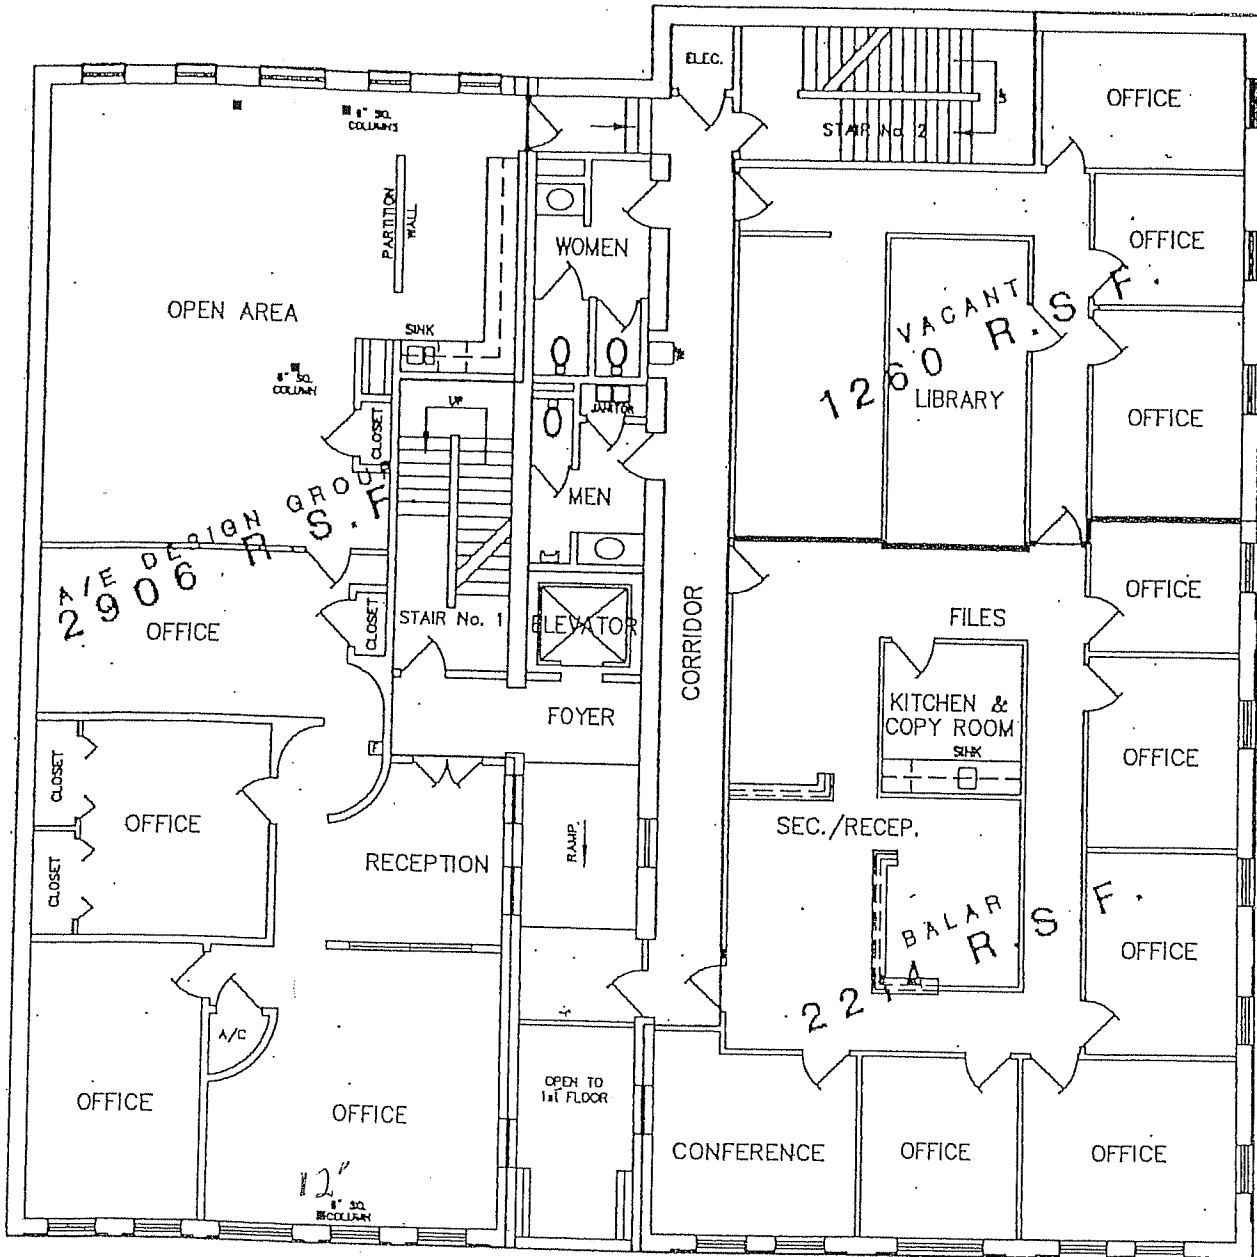

BLANCHARD BUILDING

SHEPHERD BUILDING

SECOND FLOOR RECORD DRAWING PLAN

SCALE: 1/8" = 1'-0"